
#### Plan Map

(s): H ROY LAMANSKY
..ct: Jefferson Soil & Water Conservation District

Legal Description: Tract 727, Farm 3681 Sec. 15, Penn Twp. Date: 1/5/2011
Field Office: Fairfield Service Center

Agency: USDA-NRCS

Assisted By: JEREMY D HOLLINGSWORTH

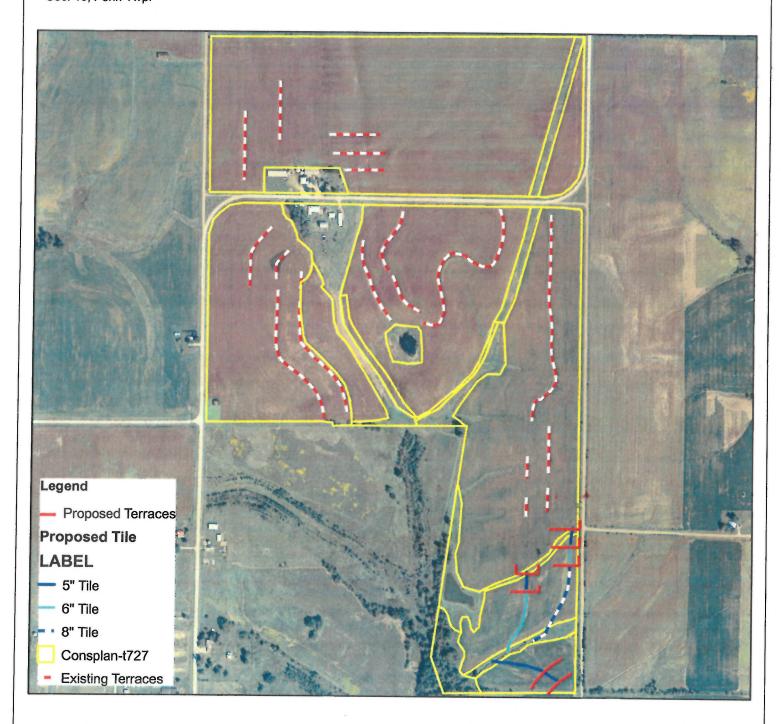







#### Conservation Plan Map

Date: 8/15/2011


Customer(s): H ROY LAMANSKY

District: JEFFERSON SOIL & WATER CONSERVATION DISTRICT

Legal Description: Farm # 3681, Tract # 727 Penn Township, Section 15 Field Office: FAIRFIELD SERVICE CENTER

Agency: USDA-NRCS

Assisted By: JENNIFER STEWART

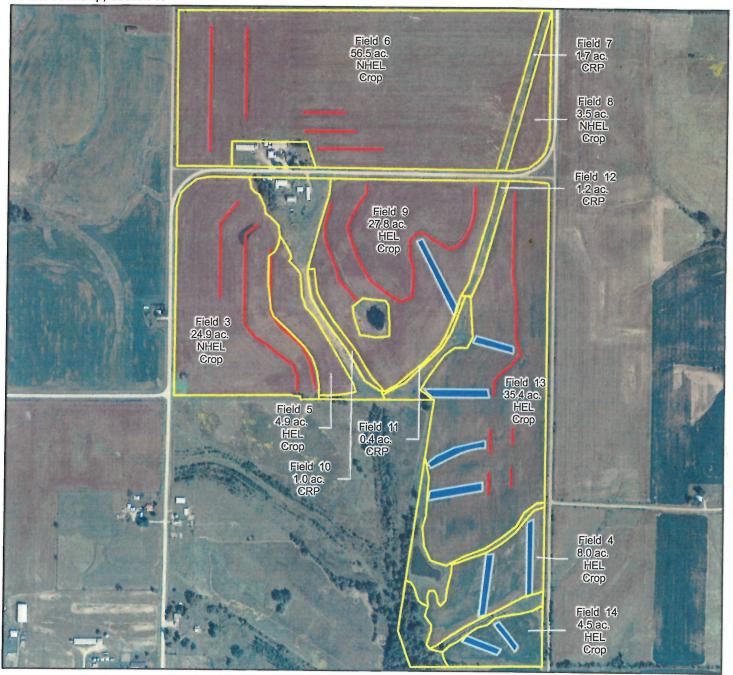




# Legend Consplan-t727 Grassed Waterways Existing Terraces





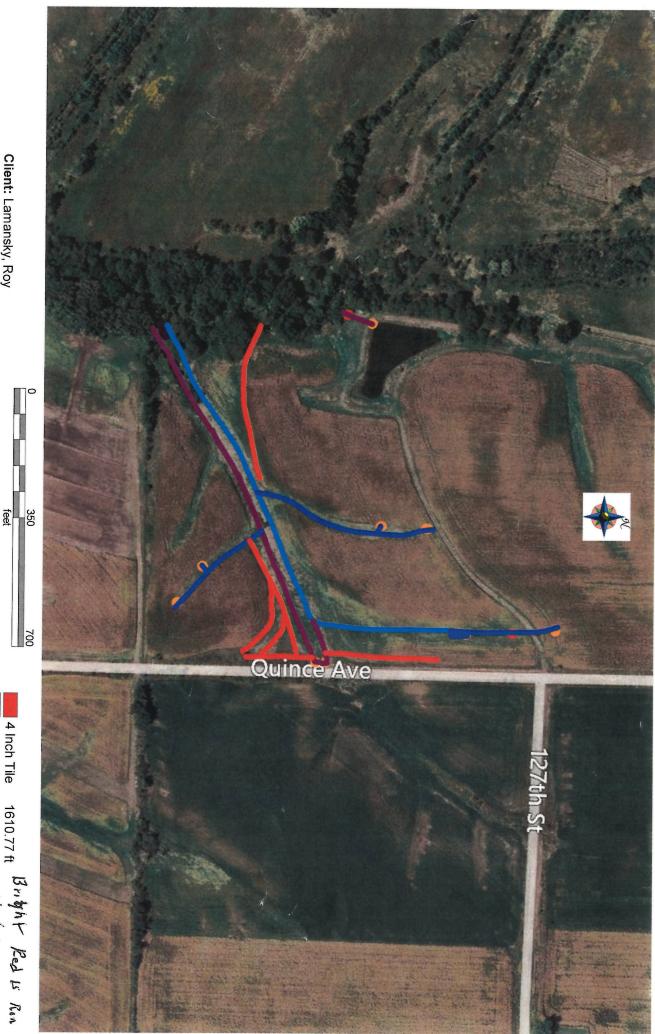

Client: Lamansky, Roy Farm: Quince Ave Field: W 7-9-13 Name: LineFeature

Irstall exta File, I know This Right, D.A Drish and

D.A. DRISH DRAINAGE, INC. 319-863-3021

4 Inch Tile 5 Inch Tile 6 Inch Tile 12 Inch Line 8 Inch Tile 1216.79 ft 1289.98 ft 1251.48 ft 39.89 ft 0.00 ft 0.00 ft

a Ideal because of wet spots Bright Red Is Ron

Where we needed Extra Tile. Two 6" Intake to Slow water From Denfeck of ou culvet own side Out Road

# Jefferson County Soil & Water Conservation District - NRCS

### 605 South 23rd Street Fairfield, IA 52556

(641) 472-4356

Dear Mr. Lamansky:

Attached are the designs for your cost share project. You were approved on the basis of an estimate for \$9,318.62, with a cost share amount of \$4,659.30. This was only an estimate. The final break down and eligible cost share for your project are listed below.


Amount	Element		Cost		Total
Earthwork					
253 ft	Terrace BB	@	\$3.72 ft	=	\$941.16
935 ft	Terrace GB	@	\$3.70 ft		\$3,459.50
Tile (Undergro	und Outlet)				
1155 ft	Tile 5"	@	\$2.78 ft	=	\$3,210.90
625 ft	Tile 6"	@	\$3.12 ft	=	\$1,950.00
1310 ft	Tile 8"	@	\$4.32 ft	=	\$5,659.20
			Total Estimate	<b>e</b> :	\$15,220.76
		Cost	Share Amoun	t: [	\$7,610.38

If this project is built as designed you are eligible for :

\$4,659.30

5/16/2013

If you have any questions or concerns please call the office immediately at (641) 472-4356. Absolutely NO TILLAGE should be done in the area work is to be completed or the project wil NOT CONTINUE! We recommend that you **DO NOT** show this estimate to the contractor.

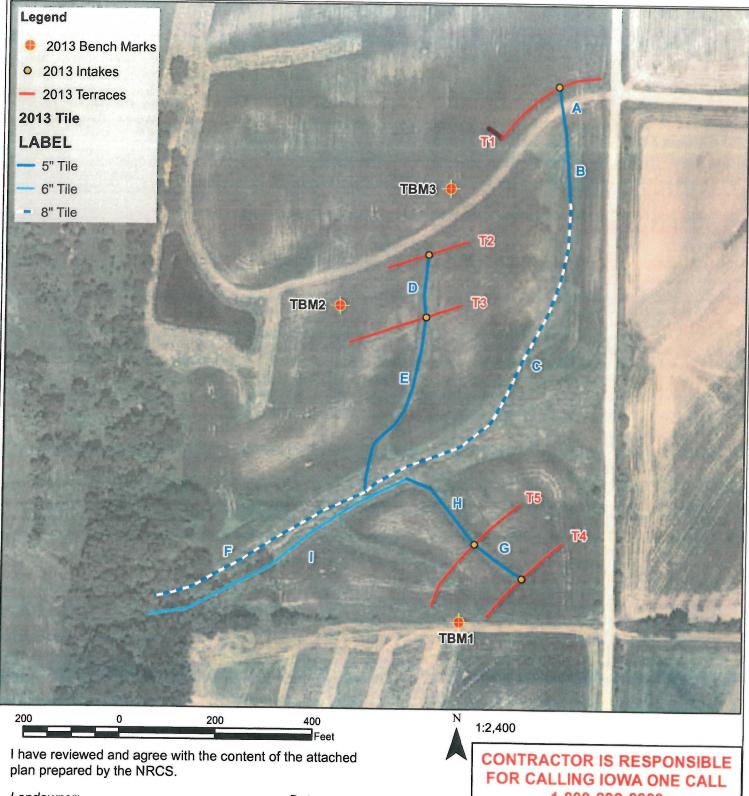

\_\_\_\_\_ Date: Landowner:

I certify that this practice has been constructed in accordance with the plans and specifications.

Contractor: \_\_\_\_\_ Date : \_\_\_\_

\_\_\_\_\_ Date : \_\_\_\_ Technician:

# 1-800-292-8989

If a cultural resource is identified during construction, stop immediately and notify the Natural Resource Conservation Service Archeologist at (515) 284-4370.




Customer(s): H ROY LAMANSKY

Legal Description: Farm # 3681, Tract # 727

Designed J.Hollingsworth	Date 5/2013	Eng. Job Class
DrawnJ.Hollingsworth	5/2013	Revision Date
Checked P. Wiley	5/13	November 200
Approved P.Wiley	5/13	Sheet 1 of 9

Eng. Job Class Revision Date lovember 2009

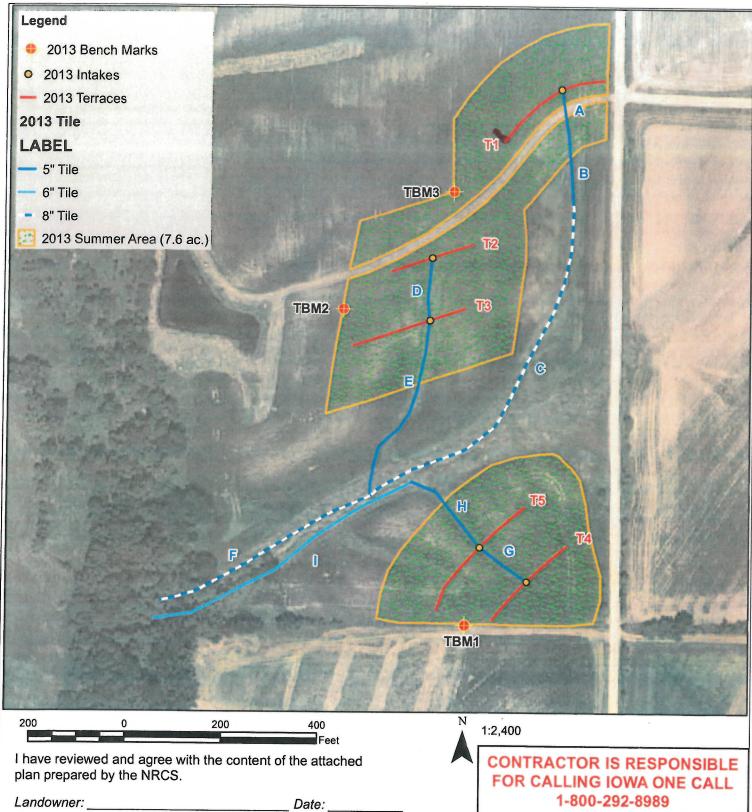

I certify that this practice has been constructed in accordance with the plans and specifications.

Contractor: \_\_\_\_\_ Date :

Technician:\_ Date :

Customer(s): H ROY LAMANSKY

Legal Description: Farm # 3681, Tract # 727 Natural Resources Conservation Service Penn Township, Section 15
United States Department of Agriculture

If a cultural resource is identified during construction, stop immediately and notify the Natural Resource Conservation Service Archeologist at (515) 284-4370.


Designed\_J.Hollingsworth Drawn J.Hollingsworth 5/2013 Checked P.Wilen 5/13 Approved P. Wiley 5/13

Eng. Job Class

Revision Date November 2009

Sheet 2 of 9



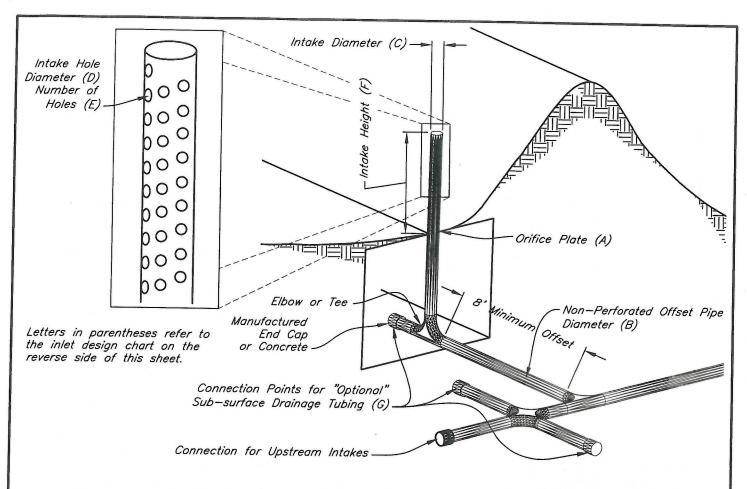

OPERATION AND MAINTENANCE REQUIREMENTS

Periodic inspections, especially immediately following significant runoff events, to keep inlets, trash guards, and collection boxes and structures clean and free of materials that can reduce flow.

Prompt repair or replacement of damaged components.

Repair or replacement of inlets damaged by farm equipment. Repair of leaks and broken or crushed lines to insure proper functioning of the conduit. Periodic checking of the outlet and animal guards to ensure proper functioning.

Repair of eroded areas at the pipe outlet.

- Maintain adequate backfill over the conduit.
- Control weeds, brush, and trees that could inpact the flow or function of the underground outlet by mechanical methods or chemicals

Cut 1.4 feet below natural ground to install intake T1. Install intake at elevation 733.1 (0.3 feet below TBM3).

Cut 1.0 feet below natural ground to install intake T2. Install intake at elevation 723.5 (6.3 feet above TBM2).

Cut 0.9 feet below natural ground to install intake T3. Install intake at elevation 710.6 (6.6 feet below TBM2).

Cut 0.2 feet below natural ground to install intake T4. Install intake at elevation 723.9 (2.5 feet below TBM1).

Do NOT cut below natural ground to install intake 15. Install intake at elevation 710.8 (15.6 feet below TBM1).

STANDARD DWG. IA-1501

Oct. 2008 PAGE 1 OF 2



UNDERGROUND OUTLET Owner: Roy Lamanski

Location: Sec\_15 , T\_73 N, R\_9 Penn Township

Jefferson County, lowa

Designed J.Hollingsworth 5/13 J.Hollingsworth 5/13

Checked P. Willy 6/13 Approved Powiley Celi3

File Name

Drawing Name IA3160516

Sheet 3 of

Terrace/Basin Data											
Terrace No.	Terrace Type*	Length (ft.)	Front Slope	Back Slope	Min. Cut Slope (ft.)	Fill (cu.yds.)	Top Width* (ft.)				
T1	BB	253	30 ft.	5:1	10:1	/	3				
T2	GB	178	30 ft.	2:1	10:1		3				
Т3	GB	248	30 ft.	2:1	5:1		3				
T4	GB	222	30 ft.	2:1	5:1		3				
T5	GB	287	30 ft.	2:1	5:1		3				
· one comb											


\* NB (Narrow Base), GB (Grassed Backslope), BB (Broad Base), GFFB (Grassed Front Farmable Back) \*\* Applicable to 638 - Water And Sediment Control Basin (WASCB) designs.

Topsoiling Required:

X YES


□ NO

#### MINIMUM DIMENSIONS FOR BROAD BASED

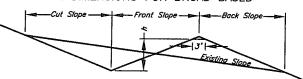


Length of cut slope, front slope and back slope shall be in increments of machinery width but not shorter than 15 feet or steeper than 5:1 h=Design height of terrace

#### MINIMUM DIMENSIONS FOR GRASSED FRONT FARMABLE BACK

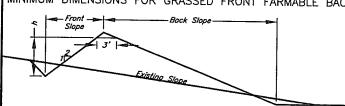

Length of back slope shall be in increments of machinery width but not shorter than 15 feet or steeper than 5:1 h=Design height of terrace


#### MINIMUM DIMENSIONS FOR GRASS BACK SLOPE

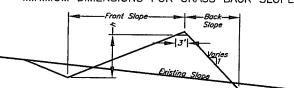

Length of front slope shall be in increments of machinery width but not shorter than 15 feet or steeper

The back slope shall be no steeper than 2:1 except when built on Ida and Monona soil series types which may have the back slope constructed no steeper than 1.5:1 h=Design height of terrace

#### MINIMUM DIMENSIONS FOR NARROW BASE

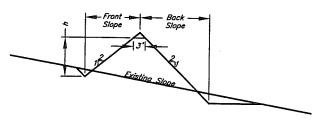

h=Design height of terrace

#### OPERATION AND MAINTENANCE REQUIREMENTS

- Remove sediment that has accumulated in the terrace channel to maintain the required capacity, a positive channel grade, and to maintain capacity where soil infiltration serves as the outlet.
- Repair sections of the terrace which have eroded or have excessive settlement or rodent damage.
- Repair or replace any damaged surface inlets.
- Fill any settled or eroded areas in the tile trench. Remove trash from around and inside the surface inlet.
- Control weeds, brush, and trees by mechanical methods or chemicals.
- Reseed and fertilize as needed to maintain good vegetation.
- Do not operate farm equipment on steep frontslopes and/or backslopes.

STANDARD DWG. IA-1500

DATE Oct. 2008 PAGE 1 OF 1



TERRACE / BASIN PLAN Owner: Roy Lamanski

Location: Sec 15 , T 73 N, R 9 W

Penn Township Jefferson County, Iowa

Stoked PW, JH Designed J.Hollingsworth 5/13 Checked P. Wiley 5/13 Approved P. Wiley 5/13

File Name

Drawing Name IA316051413

Sheet 4 of 9

Report Generated

05/16/2013

Iowa Contractor Checkout Sheet 4/01/2013

#### **Contractor Cut Sheet**

Project Name: Roy Lamansky

Project Description:

Designed by: J.Hollingsworth

Designed By Date: 5/2013

Location:
Practice:
Checked by:
Checked By Date:

Terrace: T1

Benchmark Elevation: 733.36

Terrace Type: STORAGE

Construction Style of Terrace

Contractor Signature

Contractor Signature

Date:

Contractor is Responsible for completing shaded CHECKOUT and signature boxes.

Co	ntractor	Cut She	et	ı	yed left to			y Lamansky							
				DESIG	N	rioject	Italile: KO	y Larnansky	Location.						
Settled De	sign Ridge Elevation:	735	5.4	Settled De	esign Ridge Hub =	2.0	feet Abov	e Hub	Shot on Hub =	CHECKOUT  Shot on Hub = Hub Elevation 733.3			733.36		
Comments	Station	Ref. Elev. (Flag line)	Chan. Elev.	Chan Cut/Fill	Ridge Elev.	Ridge Fill	Front Slope Width	Bottom Width	Chan.Rod	Chan. Elev.	Ridge Rod	Ridge Elev.	Difference Hub to Ridge		
	0+00	736.0	736.0		736.2	0.2 F	30.0	0.0					-2.8		
	0+50.0	734.6	734.1	0.5 C	735.5	0.9 F	30.0	0.0	Tark Charles				-2.1		
Intake	1+00	734.5	733.1	1.4 C	735.6	1.1 F	30.0	0.0					-2.2		
	1+50.0	734.5	733.5	1.0 C	735.6	1.1 F	30.0	0.0	A Contractor				-2.2		
	2+00	734.7	734.1	0.6 C	735.6	0.9 F	30.0	0.0	7. 10 20 20 20				-2.2		
	2+50.0	735.0	734.9	0.1 C	735.6	0.6 F	30.0	0.0	TO STATE OF STREET						
Block	2+53.0	735.0	735.0		735.6	0.6 F	30.0	*Full-Ht.					-2.2		

Report Generated

05/16/2013

Iowa Contractor Checkout Sheet 4/01/2013

#### **Contractor Cut Sheet**

Project Name: Roy Lamansky

Project Description:

**Contractor Signature** 

Designed by: J.Hollingsworth

Designed By Date: 5/2013

Location: Practice: Checked by: Checked By Date:

Terrace Type: STORAGE

Terrace: T2 Benchmark Elevation: 717.18

Description: TBM2-1x2 hub w/lath SW of T2 by edge of summer area I certify that this practice has been constructed in accordance with the plans and specification

Construction Style of Terrace **Grass Back Terrace** 

Contractor is Responsible for completing shaded CHECKOUT and signature boxes.

Date:

Co	ntractor	Cut She	D.P	1	yed left to									
	iii actos	Cat Sile		DESIG	NI .	Project	roject Name: Roy Lamansky Location:							
Settled Des	sign Ridge			_					CHECKOUT					
	Elevation:	725	3.8	1	esign Ridge Hub =	8.6	feet Abov	re Hub	Shot on Hub =	ot on Hub = Hub Elevation		717.	717.18	
Comments	Station	Ref. Elev. (Flag line)	Chan. Elev.	Chan Cut/Fill	Ridge Elev.	Ridge Fill	Front Slope Width	Bottom Width	Chan.Rod	Chan. Elev.	Ridge Rod	Ridge Elev.	Difference Hub to Ridge	
Block	0+00	726.3	726.3		726.6	0.3 F	0.0*	*Full-Ht. Storage Block	A STATE OF				-9.4	
	0+50.0	725.8	724.7	1.1 C	725.9	0.1 F	30.0	0.0			The Residence		-8.7	
Intake	0+89.0	724.5	723.5	1.0 C	726.0	1.5 F	30.0	0.0					-8.8	
	1+00	724.4	723.6	0.8 C	726.0	1.6 F	30.0	0.0					-8.8	
	1+50.0	724.2	724.0	0.2 C	726.0	1.8 F	30.0	0.0	Mary 18		100000000000000000000000000000000000000		-8.8	
Block	1+78.0	724.2	724.2		726.0	1.8 F	0.0*	*Full-Ht. Storage Block			E CONSTR		-8.8	

Report Generated 05/16/2013

Checked By Date:

Iowa Contractor Checkout Sheet 4/01/2013

#### **Contractor Cut Sheet**

Project Name: Roy Lamansky

Project Description:

Designed by: J.Hollingsworth

Designed By Date: 5/2013

Location: Practice: Checked by:

Terrace Type: STORAGE

Terrace: T3 Benchmark Elevation: 717.18

Description: TBM2-1x2 hub w/lath NW of T3 by edge of summer area

Construction Style of Terrace

Grass Back Terrace

I certify that this practice has been constructed in accordance with the plans and specification

**Contractor Signature** 

Contractor is Responsible for completing shaded CHECKOUT and signature boxes.

Co	ntracto	Cut She	et			Project	Name: Roy	Lamansky			Location			
			1 1 1	DESIG	N				CHECKOUT					
	sign Ridge Elevation:	713	.4	1	esign Ridge Hub =	3.8	feet Belov	v Hub	Shot on Hub =		Hub Elevation	717.	18	
Comments	Station	Ref. Elev. (Flag line)	Chan. Elev.	Chan Cut/Fill	Ridge Elev.	Ridge Fill	Front Slope Width	Bottom Width	Chan.Rod	Chan. Elev.	Ridge Rod	Ridge Elev.	Difference Hub to Ridge	
	0+00	715.8	715.8		716.0	0.2 F	30.0	0.0					1.2	
	0+50.0	713.4	713.4		713.5	0.1 F	30.0	0.0	190000000000000000000000000000000000000				3.7	
	0+80.0	711.0	711.0		713.6	2.6 F	30.0	0.0			With the same and		3,6	
	1+00	711.5	710.8	0.7 C	713.6	2.1 F	30.0	0.0					3.6	
Intake	1+20.0	711.5	710.6	0.9 C	713.6	2.1 F	30.0	0.0					3.6	
	1+50.0	711.3	711.2	0.1 C	713.6	2.3 F	30.0	0.0					3.6	
	2+00	713.5	713.5		713.7	0.2 F	30.0	0.0					3.5	
	2+48.0	714.3	714.3		714.5	0.2 F	30.0	0.0	75 TABLE				2.7	

Report Generated

05/16/2013

Iowa Contractor Checkout Sheet 4/01/2013

#### **Contractor Cut Sheet**

Project Name: Roy Lamansky

Project Description:

Designed by: J.Hollingsworth

Designed By Date: 5/2013

Location: Practice: Checked by: Checked By Date:

Terrace Type: STORAGE

Benchmark Elevation: 726.41

Description: TBM1-1x2 hub w/lath between T4 & T5 along South fence

Construction Style of Terrace **Grass Back Terrace** 

I certify that this practice has been constructed in accordance with the plans and specification

**Contractor Signature** 

Contractor is Responsible for completing shaded CHECKOUT and signature boxes.

**Technician Signature** 

Со	ntractor	Cut She	et			Project	Name: Roy	y Lamansky			Location		
				DESIG							CHECKOUT		
Settled De	sign Ridge Elevation:	121	.1		esign Ridge Hub =	0.7	feet Abov	e Hub	Shot on Hub =		Hub Elevation	726.	41
Comments	Station	Ref. Elev. (Flag line)	Chan. Elev.	Chan Cut/Fill	Ridge Elev.	Ridge Fill	Front Slope Width	Bottom Width	Chan.Rod	Chan. Elev.	Ridge Rod	Ridge Elev.	Difference Hub to Ridge
Block	0+00	727.1	727.1		727.4	0.3 F	0.0*	*Full-Ht. Storage Block			E TO CHANGE		-1.0
	0+50.0	725.4	725.4		727.4	2.0 F	30.0	0.0	THE REST				-1.0
	1+00	724.0	724.0		727.4	3.4 F	30.0	0.0					-1.0
Intake	1+05.0	724.1	723.9	0.2 C	727.4	3.3 F	30.0	0.0					-1.0
	1+50.0	725.2	725.2		727.4	2.2 F	30.0	0.0	THE RESERVE			-	-1.0
	2+00	727.8	727.8		728.0	0.2 F	30.0	0.0	25 × 12				-1.6
	2+22.0	728.2	728.2		728.4	0.2 F	30.0	0.0					-2.0

Report Generated

05/16/2013

Iowa Contractor Checkout Sheet 4/01/2013

#### **Contractor Cut Sheet**

Project Name: Roy Lamansky

Project Description:

Designed by: J.Hollingsworth

Designed By Date: 5/2013

Location: Practice: Checked by Checked By Date:

Terrace Type: STORAGE

Terrace: T5 Benchmark Elevation: 726.41

Description: TBM1-1x2 hub w/lath between T4 & T5 along South fence

Construction Style of Terrace

Grass Back Terrace


I certify that this practice has been constructed in accordance with the plans and specification

**Contractor Signature** 


Contractor is Responsible for completing shaded CHECKOUT and signature boxes.

**Technician Signature** 


Auditional (	Jomments			Surve	ea leπ to i	right lookir	ng downsti	ream					
Co	ntracto	Cut She	et			Project	Name: Ro	y Lamansky			Location	:	
				DESIG	N						CHECKOUT		
Settled De	sign Ridge Elevation:	713	.7	1	esign Ridge Hub =	12.7	7 feet Belo	w Hub	Shot on Hub =	474	Hub Elevation	726.	41
Comments	Station	Ref. Elev. (Flag line)	Chan. Elev.	Chan Cut/Fill	Ridge Elev.	Ridge Fill	Front Slope Width	Bottom Width	Chan.Rod	Chan. Elev.	Ridge Rod	Ridge Elev.	Difference Hub to Ridge
	0+00	718.7	718.7		719.0	0.3 F	30.0	0.0	STATE OF THE PARTY				7.4
	0+50.0	713.2	713.2		713.9	0.7 F	30.0	0.0	A THE STATE OF		Residence.		12.5
	1+00	712.0	712.0		713.9	1.9 F	30.0	0.0	THE REAL PROPERTY.				12.5
	1+50.0	710.9	710.9		714.0	3.1 F	30.0	0.0					12.4
Intake	1+59.0	710.8	710.8	EXEC	714.0	3.2 F	30.0	0.0	基础加速		4-1-1-1-1	at the second	12.4
	2+00	711.8	711.8		714.0	2.2 F	30.0	0.0	(C) (C) (C) (C)				12.4
	2+50.0	714.6	714.6		714.9	0.3 F	30.0	0.0	631033				11.5
Block	2+87.0	716.2	716.2		716.5	0.3 F	0.0*	*Full-Ht. Storage Block					9.9

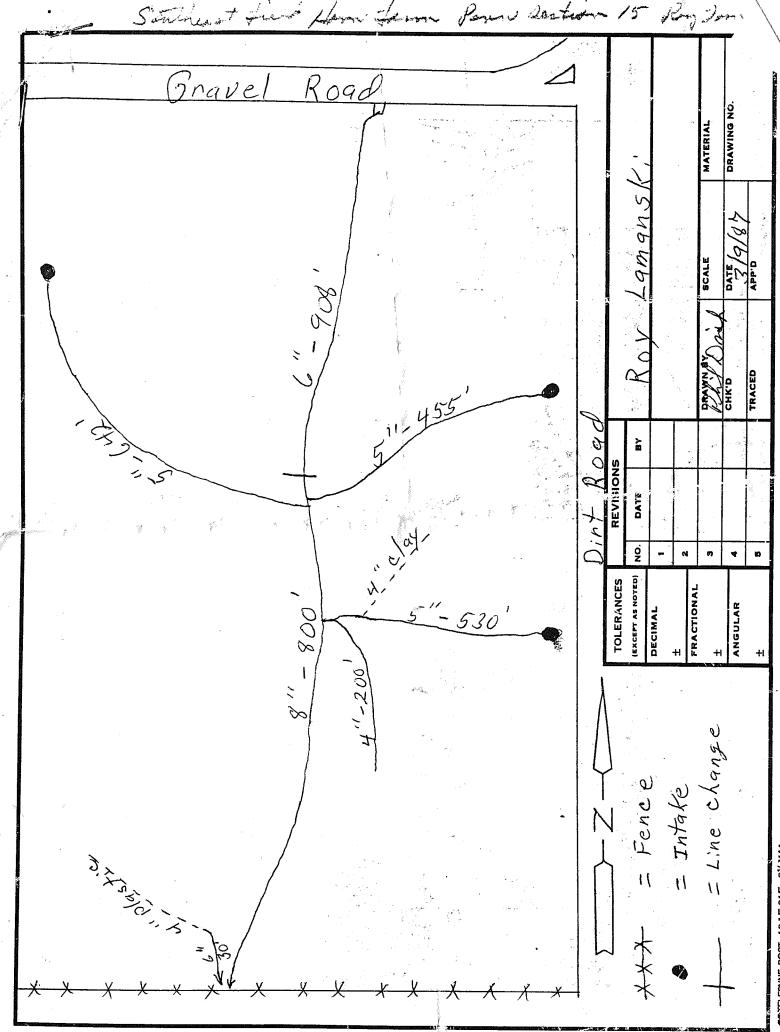

TOTELEDYNE POST 18AE-01E-8%X11

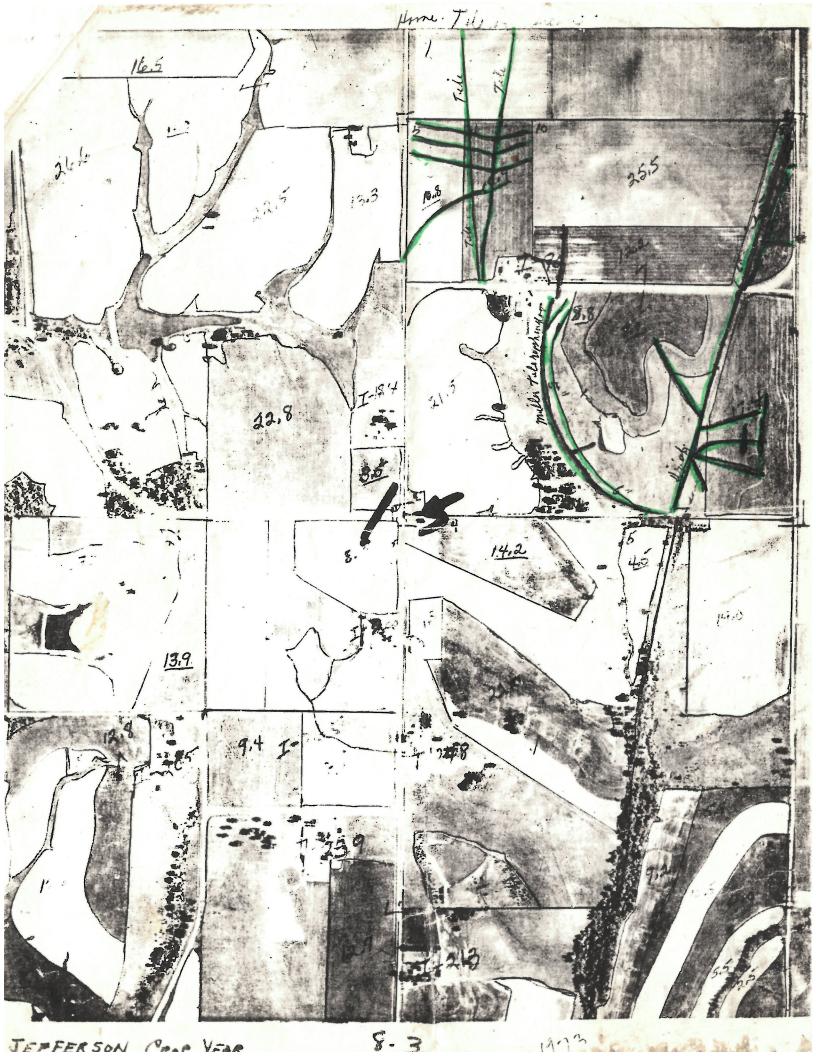




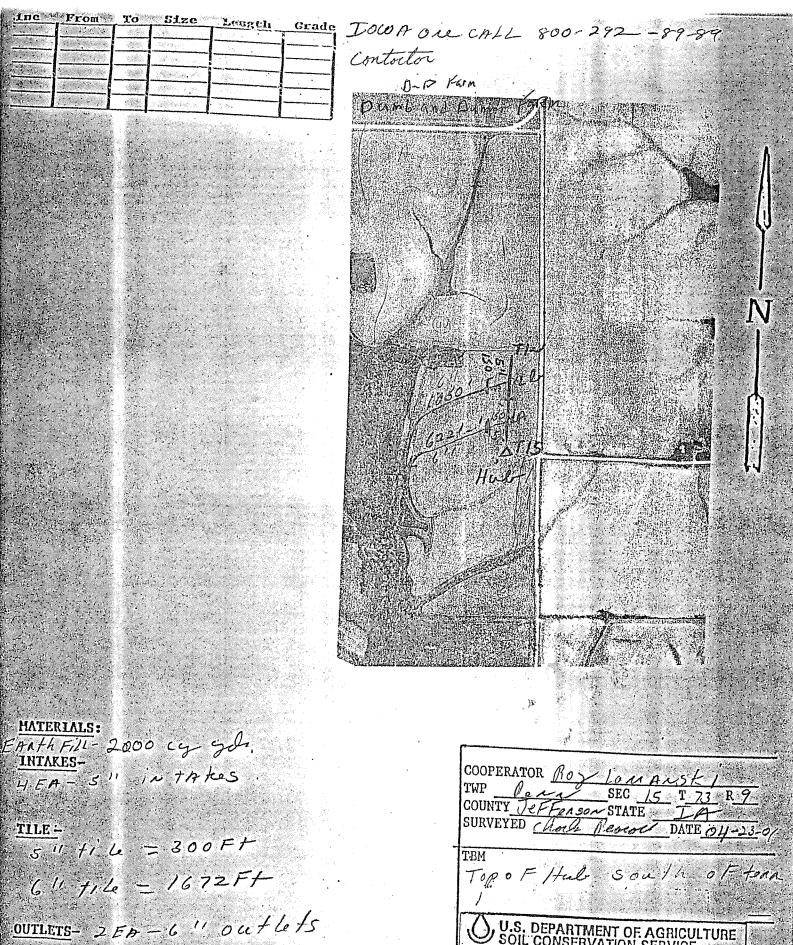

U.S. DEPARTMENT OF AGRICULTURE
SOIL CONSERVATION SERVICE

Designed Date
Approved by Pennel
Title
Staked Title
Sheet Drawing Ho.
Checked Milling 4/22/A, No. / Drawing Ho.

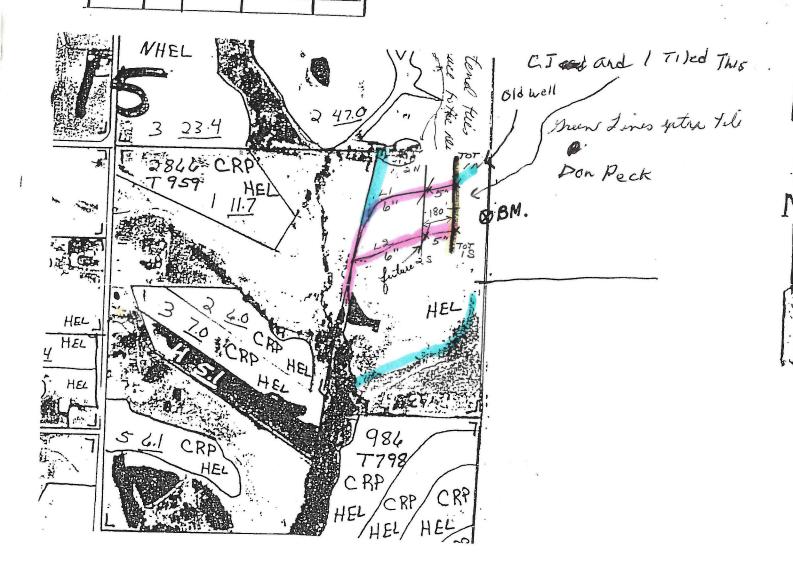

MATERIALS: 650ft. Narrow front Far valle Sacker

INTAKES-

4-5" intakin all 3' tall from national grounds.

TILE: 400 ft. 5"

1325 ft. 6"

300 ft. 8" (may not be needed if
what into drawings ditar)


OUTLETS-1-8"outlet.

DATE 11-21-00 TBM Mail in fence part, East

U.S. DEPARTA	MENT O	F. AGRICULTURE
200 Pate	Approv	-1 - 0
Staked	Title Sheet No	Drawing No.
Checked	of ·	1

## STATE COST SHARE RATES


100 = =	1		SIVI	E CO	BL BHYLE	RAT	E8			
6501.12	NAME /	9				•		•		,
("	ring	Lanus	wke	1	_DATE	1	/- 2/			
	EARTHWORK		1		,		1-21-	00	· · · · · · · · · · · · · · · · · · ·	
	mi -				TOTAL	ւ /	50%	COST	BHARE	
	Terrace or BROADBASE					<u>_</u>				
· / · / · · ·	PHONDHARE		_ [t	. at	2.50	or	1 25			
ST/NY/S,	GRASSBACK	(250	<i>5</i> 1				4 • 25	per	[t	
- F	·	650	IU.	• at	2.24	or	1.12	per	[t. 728	
•	NARROWBASE		ſt.	at	1 74				_	
	TILE		<del>_</del>		1.74	or.	.87	per	ft	
11.40		200	6.1							
relatinte	61	400	_ 16.	at	1.10	ΟĽ	. 55	ber	ft. 220.00	****
reldinte thet inter ainogedate the the	,6" Tile	1325	ſt.	a t	1.26			POL	220.00	
are the	8" Tile				- <del>-</del>	01:	.63	per	ft. <u>834,75</u>	
her the you		300	_ (t.	at	2.00	ΟĽ				
a llo active	"10" Tile		ſt.	at	2 20				It. <u>300,0</u> 0	
he per	v 12". Tile					Oξ	1.55	per	Et	
the way ou			_ [t.	.at	4.20	01.				
	INLETS,5	2			ea.				ft	
	6" Regular		un.	аt	<i>80.00</i> 100.00	G 15	40.00		80.00	
	8" Regular					01.	50.00	per e	30.0 <sub>0</sub>	
			_ un.	at	120.00	or	60.00	per e	ea	
	10" Regular		_ un.	at	130.00	ar				
	6" Offset	2			90.00	O L	45.00	per e	ea	
			un.	at	115.00	or			90.00 ea	
	8" Offset		un	at	130.00					
10	2" Regular (	letted)	uN	17	210.00		60.00	per e	ea	•
	5" 16'						105.00	jeu e	٠,	
	10		_,un.	аt	100.00	or	50.00	ner -		•
	6" 16'		1111	5 h	100 -					
	8" 16'		_ *****	at	100.00	01.	50.00	per e	ea.	
	8" 16'	/	un.	at	110.00	or				
	10" 20'						55.00	per e	:a <u>55</u>	
	20		un.	at	130.00	or	65.00			•
	12" 20'						_	her 6	· a .	
	•		un.	at	160.00	or	80.00	per e	e a	
	TILE INCLUDINGE INCL	RE OPPO	*771 ***					<u> </u>		
	INLETS INCL	UDE BACKII	OE A	א תע יטטי	n 'SNerdany	CVBE	TRENC	HING,	ETC.	
	COTHUTE THE	LUDE BACK	JIOE 1	VND :	ικατατίβ. Ο Ταπατίβ	13 5.1.		·	<del></del>	
	(un=unit)	-		-	क्तानंसप्रसः सिर्	MKD	• .	_	use	9/5
	-				CORT or	ם ת גל	211000	25	37.76/2600	1.00
				•	COBT BI	MKE.	типони	23	07.75+230	
•		•			TOTAL A	Mour	4ih			
					•			53	00.00	

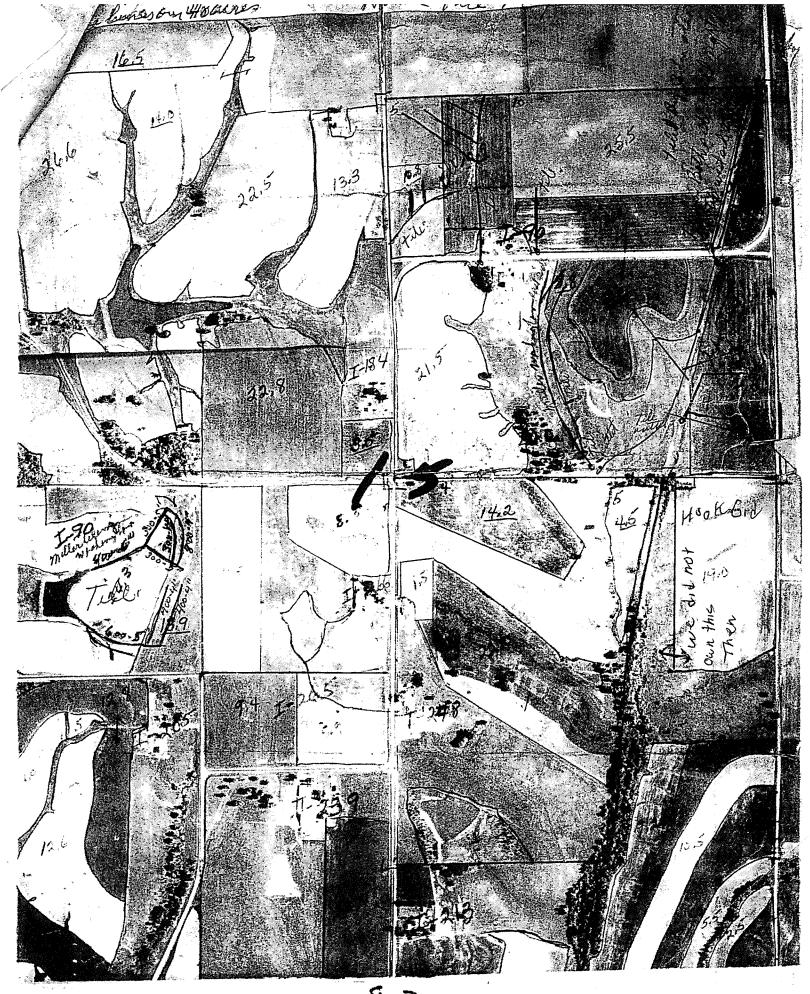

JEPFERSON CROP YEAR 1970

ine	From	То	Size	Length	Grade
MIL	sut	let	- 5"	600	1.6
eld.	Return.		6"	_600_	1.6
				_183 <u>0</u>	

The Lletch this map shows the tile on West side and theather map is

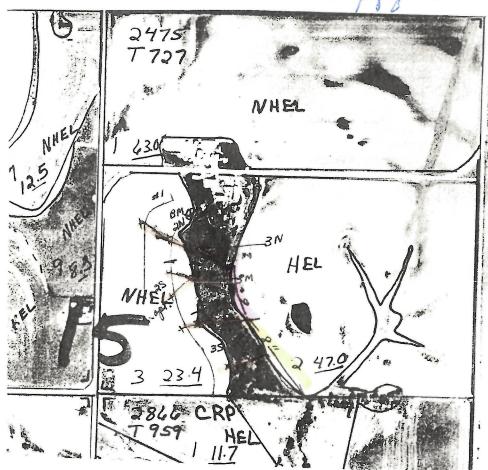

CURT this is South of House Home FARM

> T 727 fuld 3 NHEL 600-3100 ft. 620-3543 TBA-5150**5** Ao.Ben. 12ac.

MATERIALS:

INTAKES-

TILE -

600 - 8" 5501 800 - 6" 6471 1830 - 5" 2346

OUTLETS-

COOPERATOR Pay Sincery:
TWP Jenn SEC 15 T 73 Rog
COUNTY of STATE day
SURVEYED DATE 10 - 97

TBM Japen west gate past ribbon


U.S. DEPARTMENT OF AGRICULTURE
SOIL CONSERVATION SERVICE

Designed Johnston Date
Designed Johnston Title Staked Sheet Drawing No No.

ike	From	То	Size	Length	حسن <i>n</i> Grade
M	aut	lat	8.	600	1.2
	let	E.F	64	600	1.6
all	laterals		_5"	1830	2
		l			

Call ONE-CALL 2 days prior to any excavation 1-800-292-8939

# FILE COPY

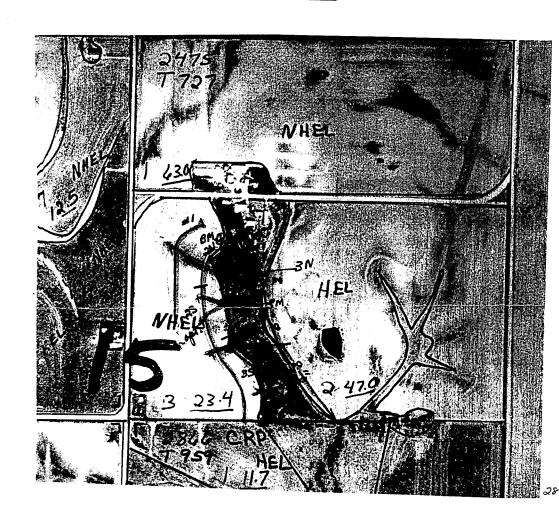

アクタケ fuld 3 NHEL 600-3100 ft. 620-35+3 28/e2 TBA - 5/508 ac. Ben. 12ac.

MATERIALS: 600' Grassback ToT 3: +550 3100ft constructed.

INTAKES-

8-6"intakes 9-6"intakes inslatted

TILE -

600-8" 800-61 23461

OUTLETS-

1-8"w/quard. 1-8"w/quard installed

TWP June SEC 15 173 609

TBM Tap of west gate past ribloses

U.S. DEPARTMENT OF AGRICULTURE SOIL CONSERVATION SERVICE

Drawing No.

No.

Slandord Drawing No. 854 - DATE: 7-95 . Sheel 1 of 2	Underground Outlet		Waterials and Construction shall be in accordance with Construction Specification for Underground Outlets (lowa 5td. 620)	Location Map			
Contractor Date Staked	and specifications.  Oesigned	teriols os	LOC	If YES, Describe:  YES  NONE KNOWN  If YES, Describe:  If a cultural resource is identified during construction, immediately notify the Cultural Resource Coordinator for the Natural Resources Conservation Service (515-284-4172)	At least 48 hours prior to performing any excavation, the continound notifying lowa One Call to locate utilities. Call 1-800-292-9989,	3	Intake Diam.  Intake Diam.  Design Height of Lerrace (See
Sheet Drawing No.	nad Titte	U.S. DEPARTMENT OF AGRICULTURE NATURAL RESOURCES CONSERVATION SERVICE	OWNER +CX LOCUMOUNSKY	NONE KNOWN  ruction, immediately notify the Cultural ces Conservation Service (515-284-4172)	At least 48 hours prior to performing any excavation, the contractor is responsible for notifying lowa One Call to locate utilities. Call 1-800-292-9989.	Offset Diam.	J' Terroce Ridge  Orlice Plate (at channel surface)

MILLER WELDING & TILING, INC. WASHINGTON, IOWA "SATISFACTION GUARANTEED" PHONE: (319) 653-2553 LOCATION PLAN 9 5091511 262'5" - LEGEND -MATERIAL USED Permanent Fence \_ \_ \_ \_ -Tile Lines Terrace Intake O Connection Х Existing Shallow Ditch\_\_\_ Existing Deep Ditch \_\_\_ ===:= TOWNSHIP \_\_\_ \_\_ \_\_

INV# 6189



waterways + field borders

СО	ST EST	IMATI	E South or Home, Help.	Houseat	
During	Constant Of	ロジアフ	-M - M7		]\$/ <del>/</del>
DATE: 4/2/01 -> P	7 This was	demo when	I had some	Kan On al	
DATE: 4/2/01 at Ains	worth , Dad	Tine the	hell out of 4	40 Duck	
TIEM	QUANTITY	UNITS	UNIT COST		
Earth fill on fence	1100	ar.yd.	1.10	1210.00	
Earthfill on old road	820		1.10	902.00	
48" WS Pipe	5	lin. ft.	85,00	425,00	
36" Nos Pipe	84	lin-ft.		5460.00	
10" T	4	lin. Ft.		58,52	
8" 7	2	lien ft.	11.71	23.42	
Fabrication 10"	2	each	79,79	159.58	
8"		each	46.20	66.20	
48"	/	each	370.62	السنان السا	
Seeding & Mulching	1.0	acre	300,00	300,00	
					-
2		!			
On Fence				8,073,34	
On Old Road			*	7,765,34	
		<u> </u>			
· · · · · · · · · · · · · · · · · · ·					1.
		j		_ Wilma-	let me
	• ;			_ Know if	They want
			!	- In huilt	44is. If
•			# #	- W DWIII	ACRAMICO
TOTAL BOT	The Art A reserve		į į	_ 60, 1'11	prepare
TOTAL EST	IMATED	COST		_plans.	prepare Also, let which use. Thanks - Su
				me kno	W Which
				もかり	we mine



www.dadrishdrainage.com

INVOICE

DATE	INVOICE à		
6/3/2014	2286		

BILL TO:

Roy Lamansky 811 S. Park Fairfield, IA 52556

TERMS	DUE DATE	PROJECT
NET DUE IN 10 DAYS	6/13/2014	

SERVICE D	CLASS	QTY.	DESCRIPTION	RATE	AMOUNT
5/19/2014	FARM	1	Service Time:600 Moving In:605	100.00	100.00
5/19/2014	FARM	1	Service Time:600 Warm Up, Fuel, Shut Down, Travel:611	0.00	0.00
5/19/2014	FARM		850C NT with operator	160.00	1,720.00
5/19/2014	FARM		Service Time:600 Fuel, Grease, Parts, Pieces:600	0.00	0.00
5/19/2014	FARM	3.5	Service Time:600 Fuel, Grease, Parts, Pieces:600	0.00	0.00
5/19/2014	FARM		850C WT with operator	160.00	1,600.00
5/20/2014	FARM		850C NT with operator	160.00	2,200.00
5/20/2014	FARM		Service Time:600 Fuel, Grease, Parts, Pieces:600	0.00	0.00
5/20/2014	FARM	8.125	850C WT with operator	160.00	1,300.00
5/20/2014	FARM		850C NT with operator	160.00	920.00
5/21/2014	FARM		850C NT with operator	160.00	240.00
5/21/2014	FARM		Service Time:600 Fuel, Grease, Parts, Pieces:600	0.00	0.00
5/21/2014	FARM		Service Time:600 Measuring & Survey:603	0.00	0.00
5/21/2014	FARM	0.25	Service Time:600 Fuel, Grease, Parts, Pieces:600	0.00	0.00
5/21/2014	FARM		850C NT with operator	160.00	720.00
5/21/2014	FARM	5.25	850C WT with operator	160.00	840.00
			Hours for Dry Hole in Large Waterway		
5/21/2014	FARM	4	850C WT with operator	160.00	640.00
			Mr. and		

A late fee of 1.5% per month will be assessed on all invoices past 30 days.

Total

\$10,280.00

Payments/Credits

\$0.00

**Balance Due** 

Pl 6-11-24

Epices